


Ground Floor Plan As-Built

Scale 1:50

PROPOSED FIT-OUT OF PREMISES AND NEW MEZZANINE LEVEL  
- 37/A/2 ENGINEER LANE, GIB., FOR EXPECT GREATNESS LTD.

Project: 37/A/2 Engineer Lane			Drawing updated to reflect as built status		
Rev	Date	Comments			
Drawn by: VC	Checked/ Approved: SM	Date: 12.08.2016			
Drg Title: As-Built Ground Floor Plan			Job No.: 0349 - P01	Media: A3	
Scale: 1:50	Rev: H	Date: 13.09.17			

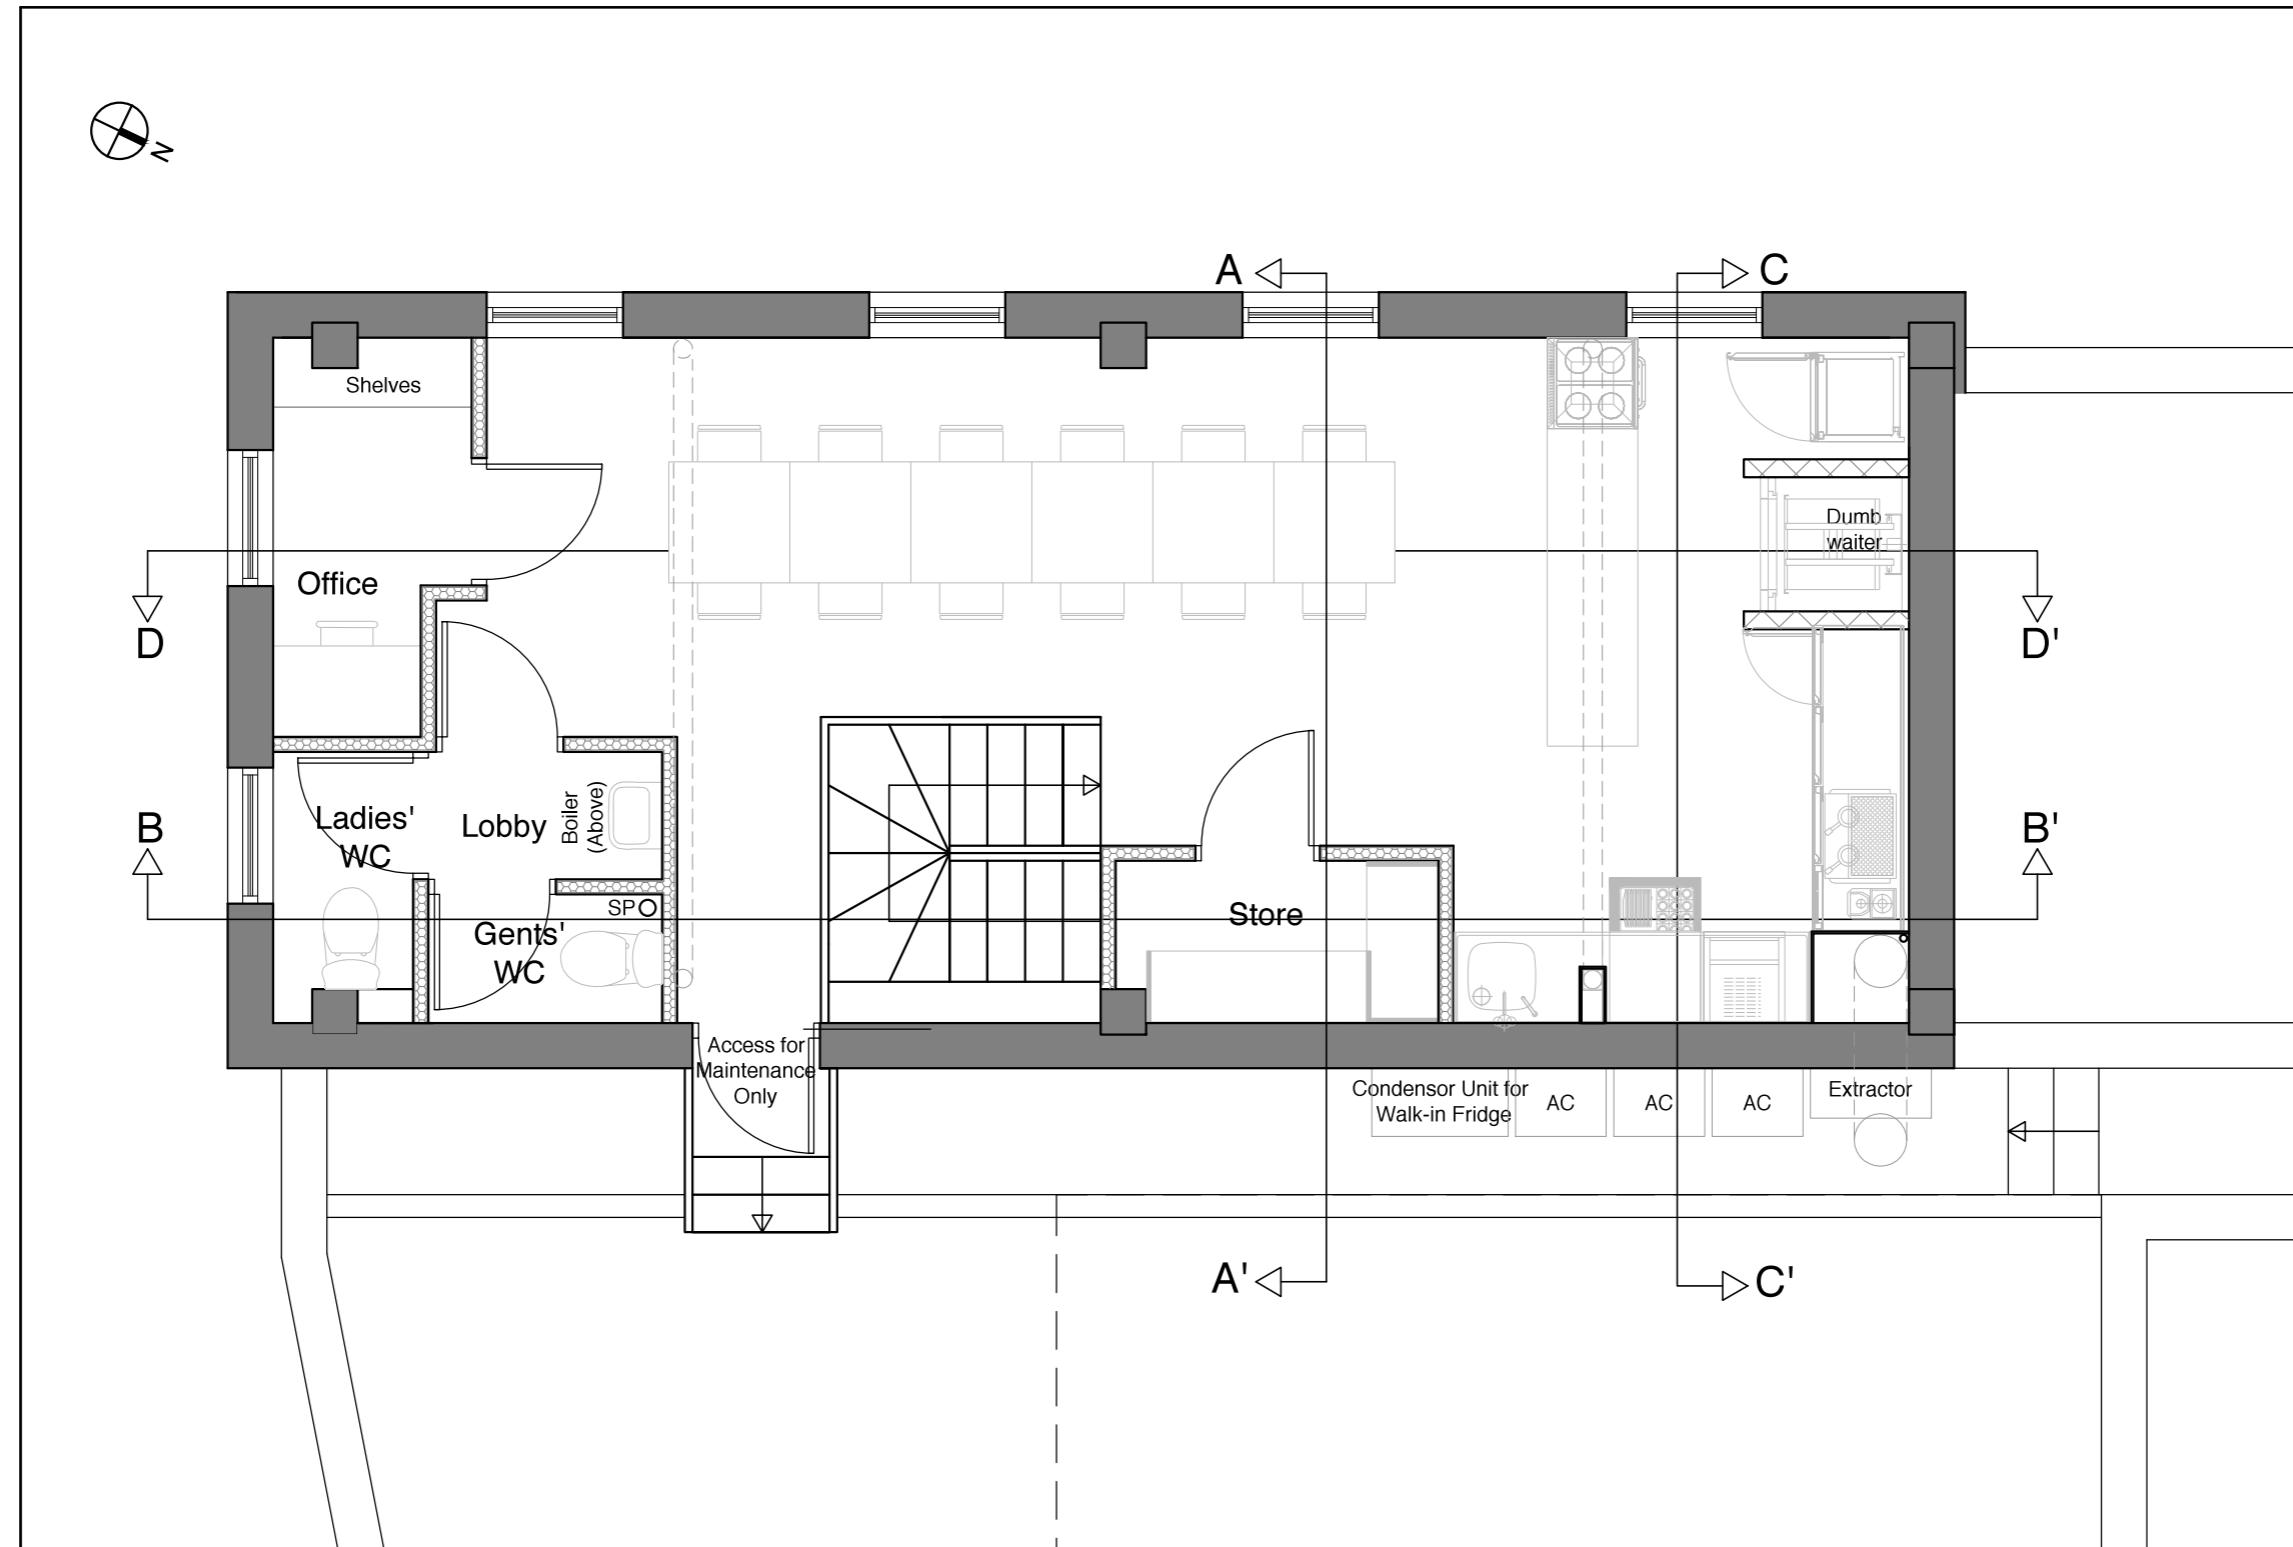


Mezzanine Floor Plan As-Built

Scale 1:50

PROPOSED FIT-OUT OF PREMISES AND NEW MEZZANINE LEVEL  
- 37/A/2 ENGINEER LANE, GIB., FOR EXPECT GREATNESS LTD.

Project: 37/A/2 Engineer Lane			Drawing updated to reflect as built status		
Rev	Date	Comments			
Drawn by: VC	Checked/ Approved: SM	Date: 12.08.2016			
Drg Title: As-Built Mezzanine Floor Plan			Job No.: 0349 - P02	Media: A3	
Scale: 1:50	Rev: L	Date: 13.09.17			

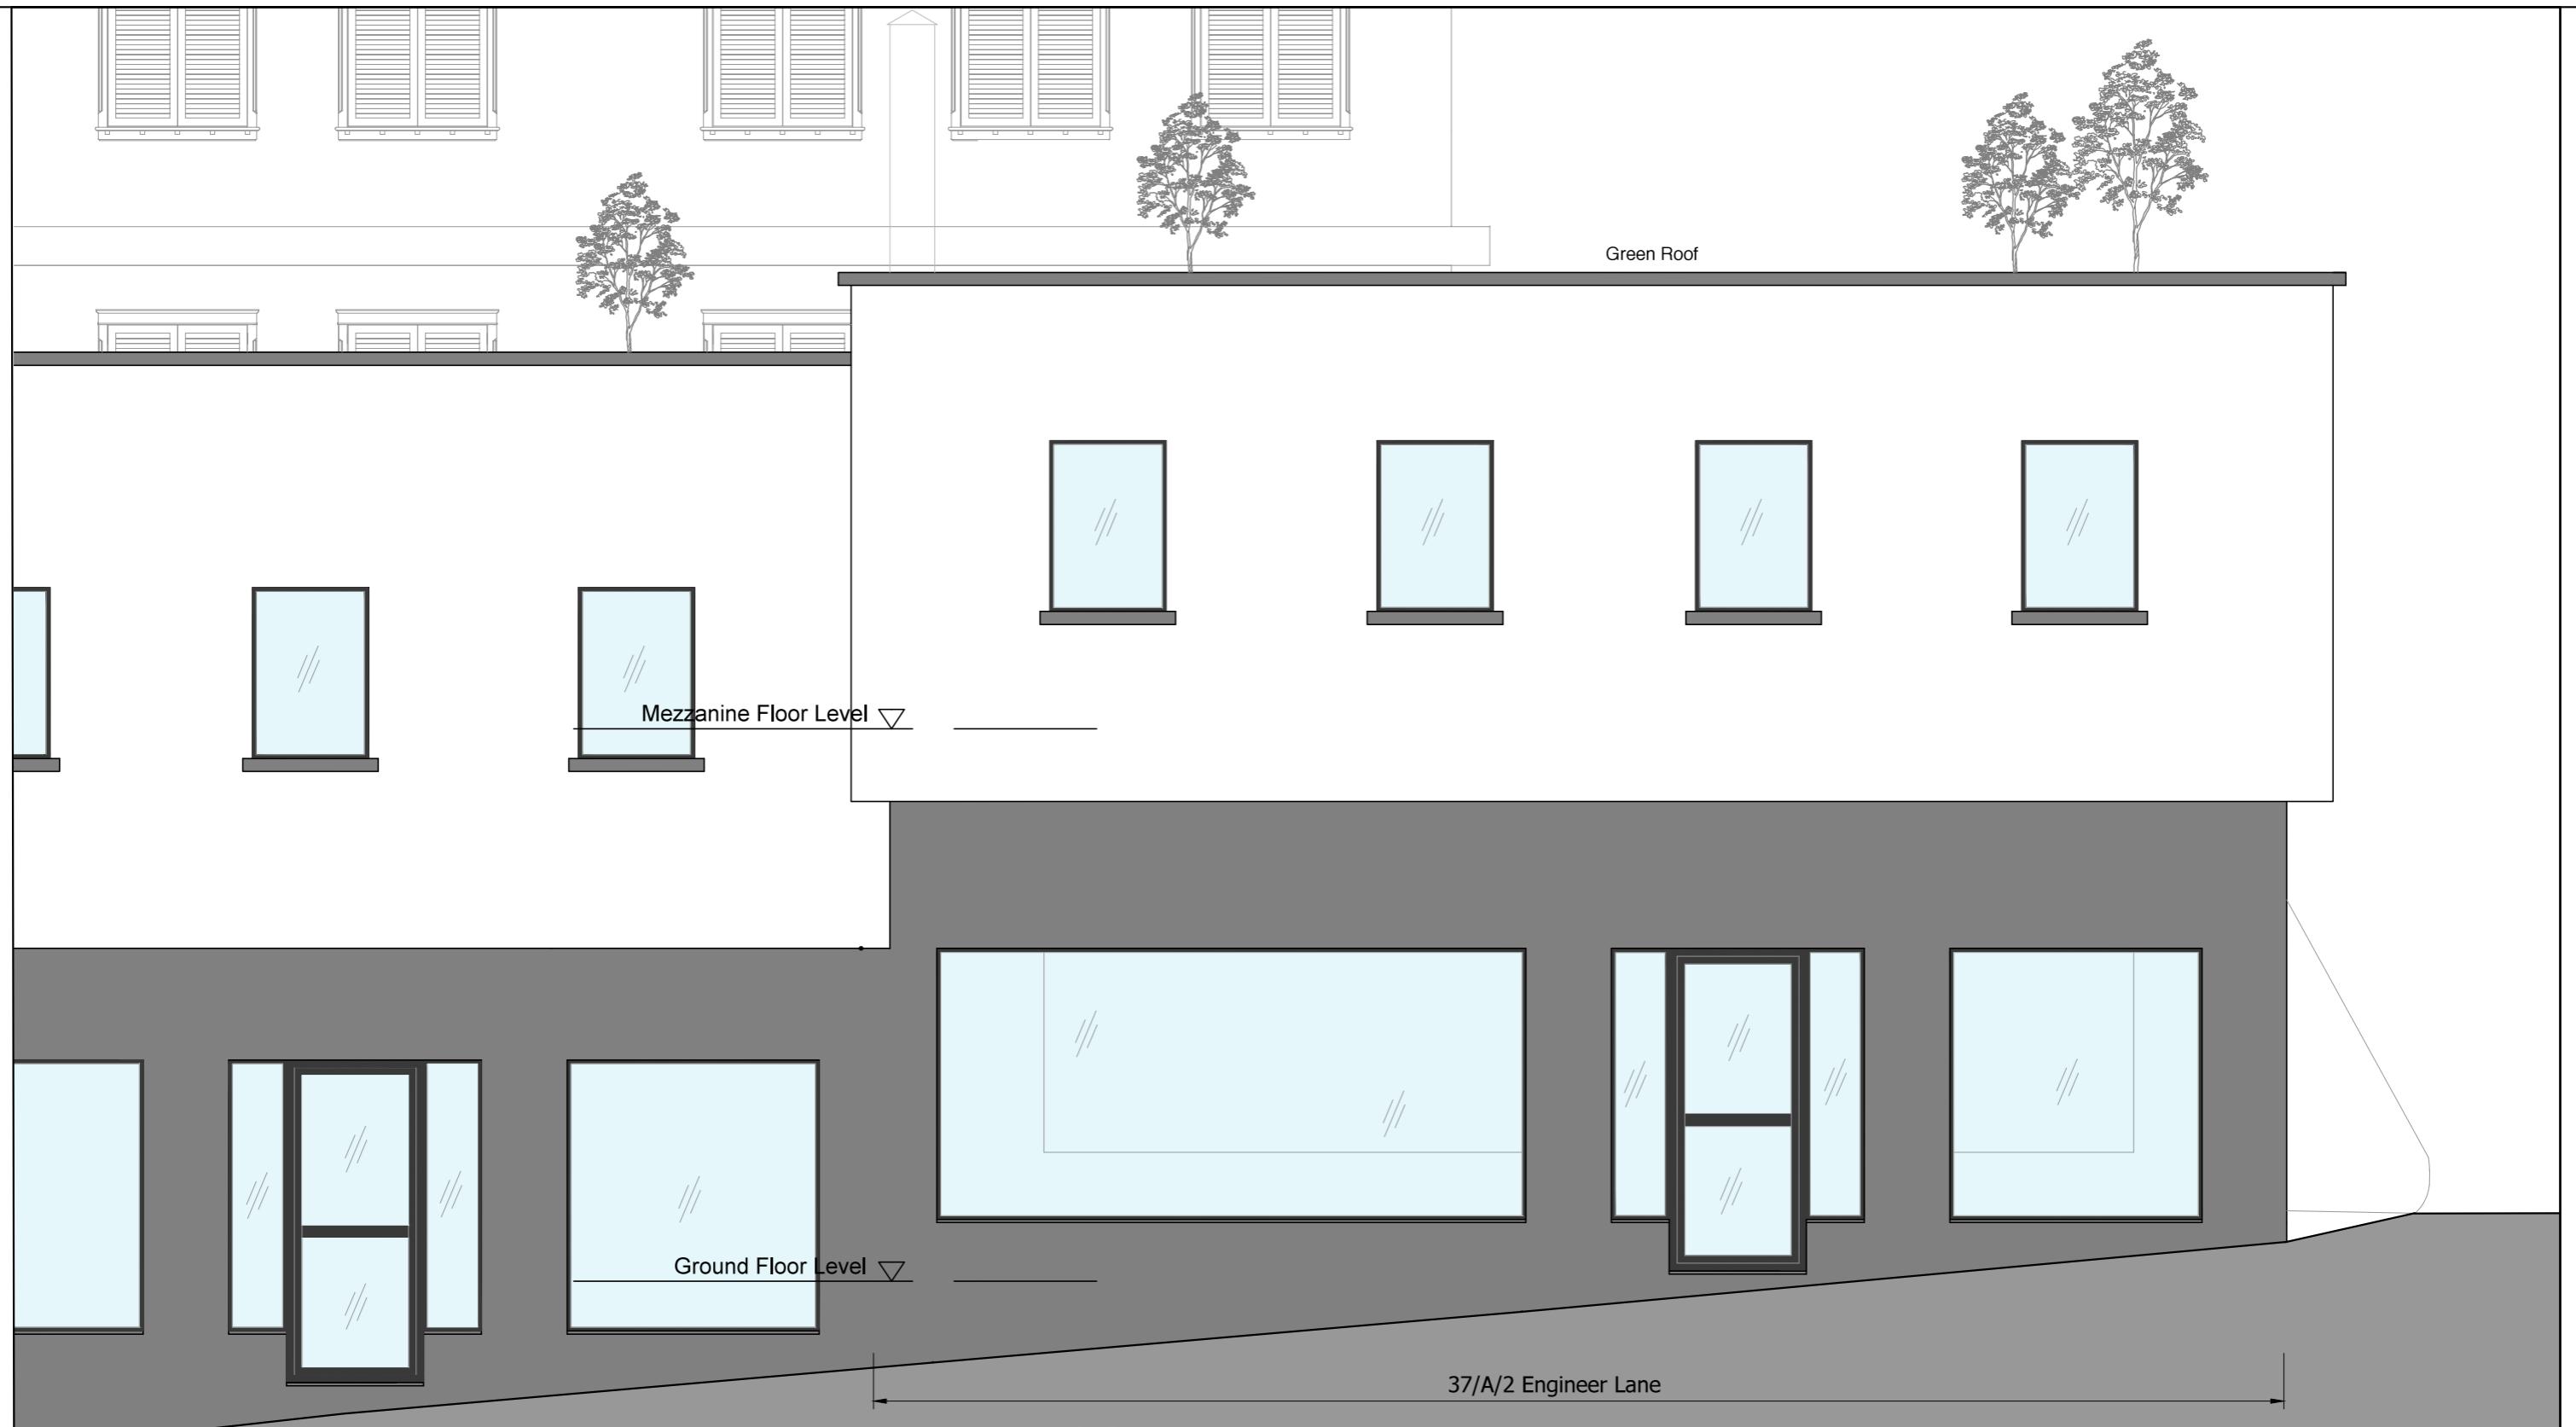

PROPOSED FIT-OUT OF PREMISES AND NEW MEZZANINE LEVEL  
- 37/A/2 ENGINEER LANE, GIB., FOR EXPECT GREATNESS LTD.

Project:  
**37/A/2 Engineer Lane**  
 Drg Title:  
**As-Built West Elevation**

B	14.09.17	Drawing updated to reflect as built status		
Rev	Date	Comments		
Drawn by: VC	Checked/ Approved: SM	Date: 02.08.2016		
Job No.: <b>0349 - P03</b>	Media: <b>A3</b>			
Scale: <b>1:50</b>	Rev: <b>B</b>	Date: <b>14.09.17</b>		



Arc Designs Ltd  
 Unit 23B Casemates, Gibraltar  
 Tel: (+350) 20064512  
 E-mail: info@arc.gi




South Elevation As-Built

Scale 1:50

PROPOSED FIT-OUT OF PREMISES AND NEW MEZZANINE LEVEL  
- 37/A/2 ENGINEER LANE, GIB., FOR EXPECT GREATNESS LTD.

			B	14.09.17	Drawing updated to reflect as built status	
			Rev	Date	Comments	
			Drawn by:	Checked/ Approved:	Date:	
			VC	SM	02.08.2016	
Project:	Drg Title:	Job No.:	Media:			
37/A/2 Engineer Lane			0349 - P04	A3		
As-Built South Elevation			Scale:	Rev:	Date:	
			1:50	B	14.09.17	

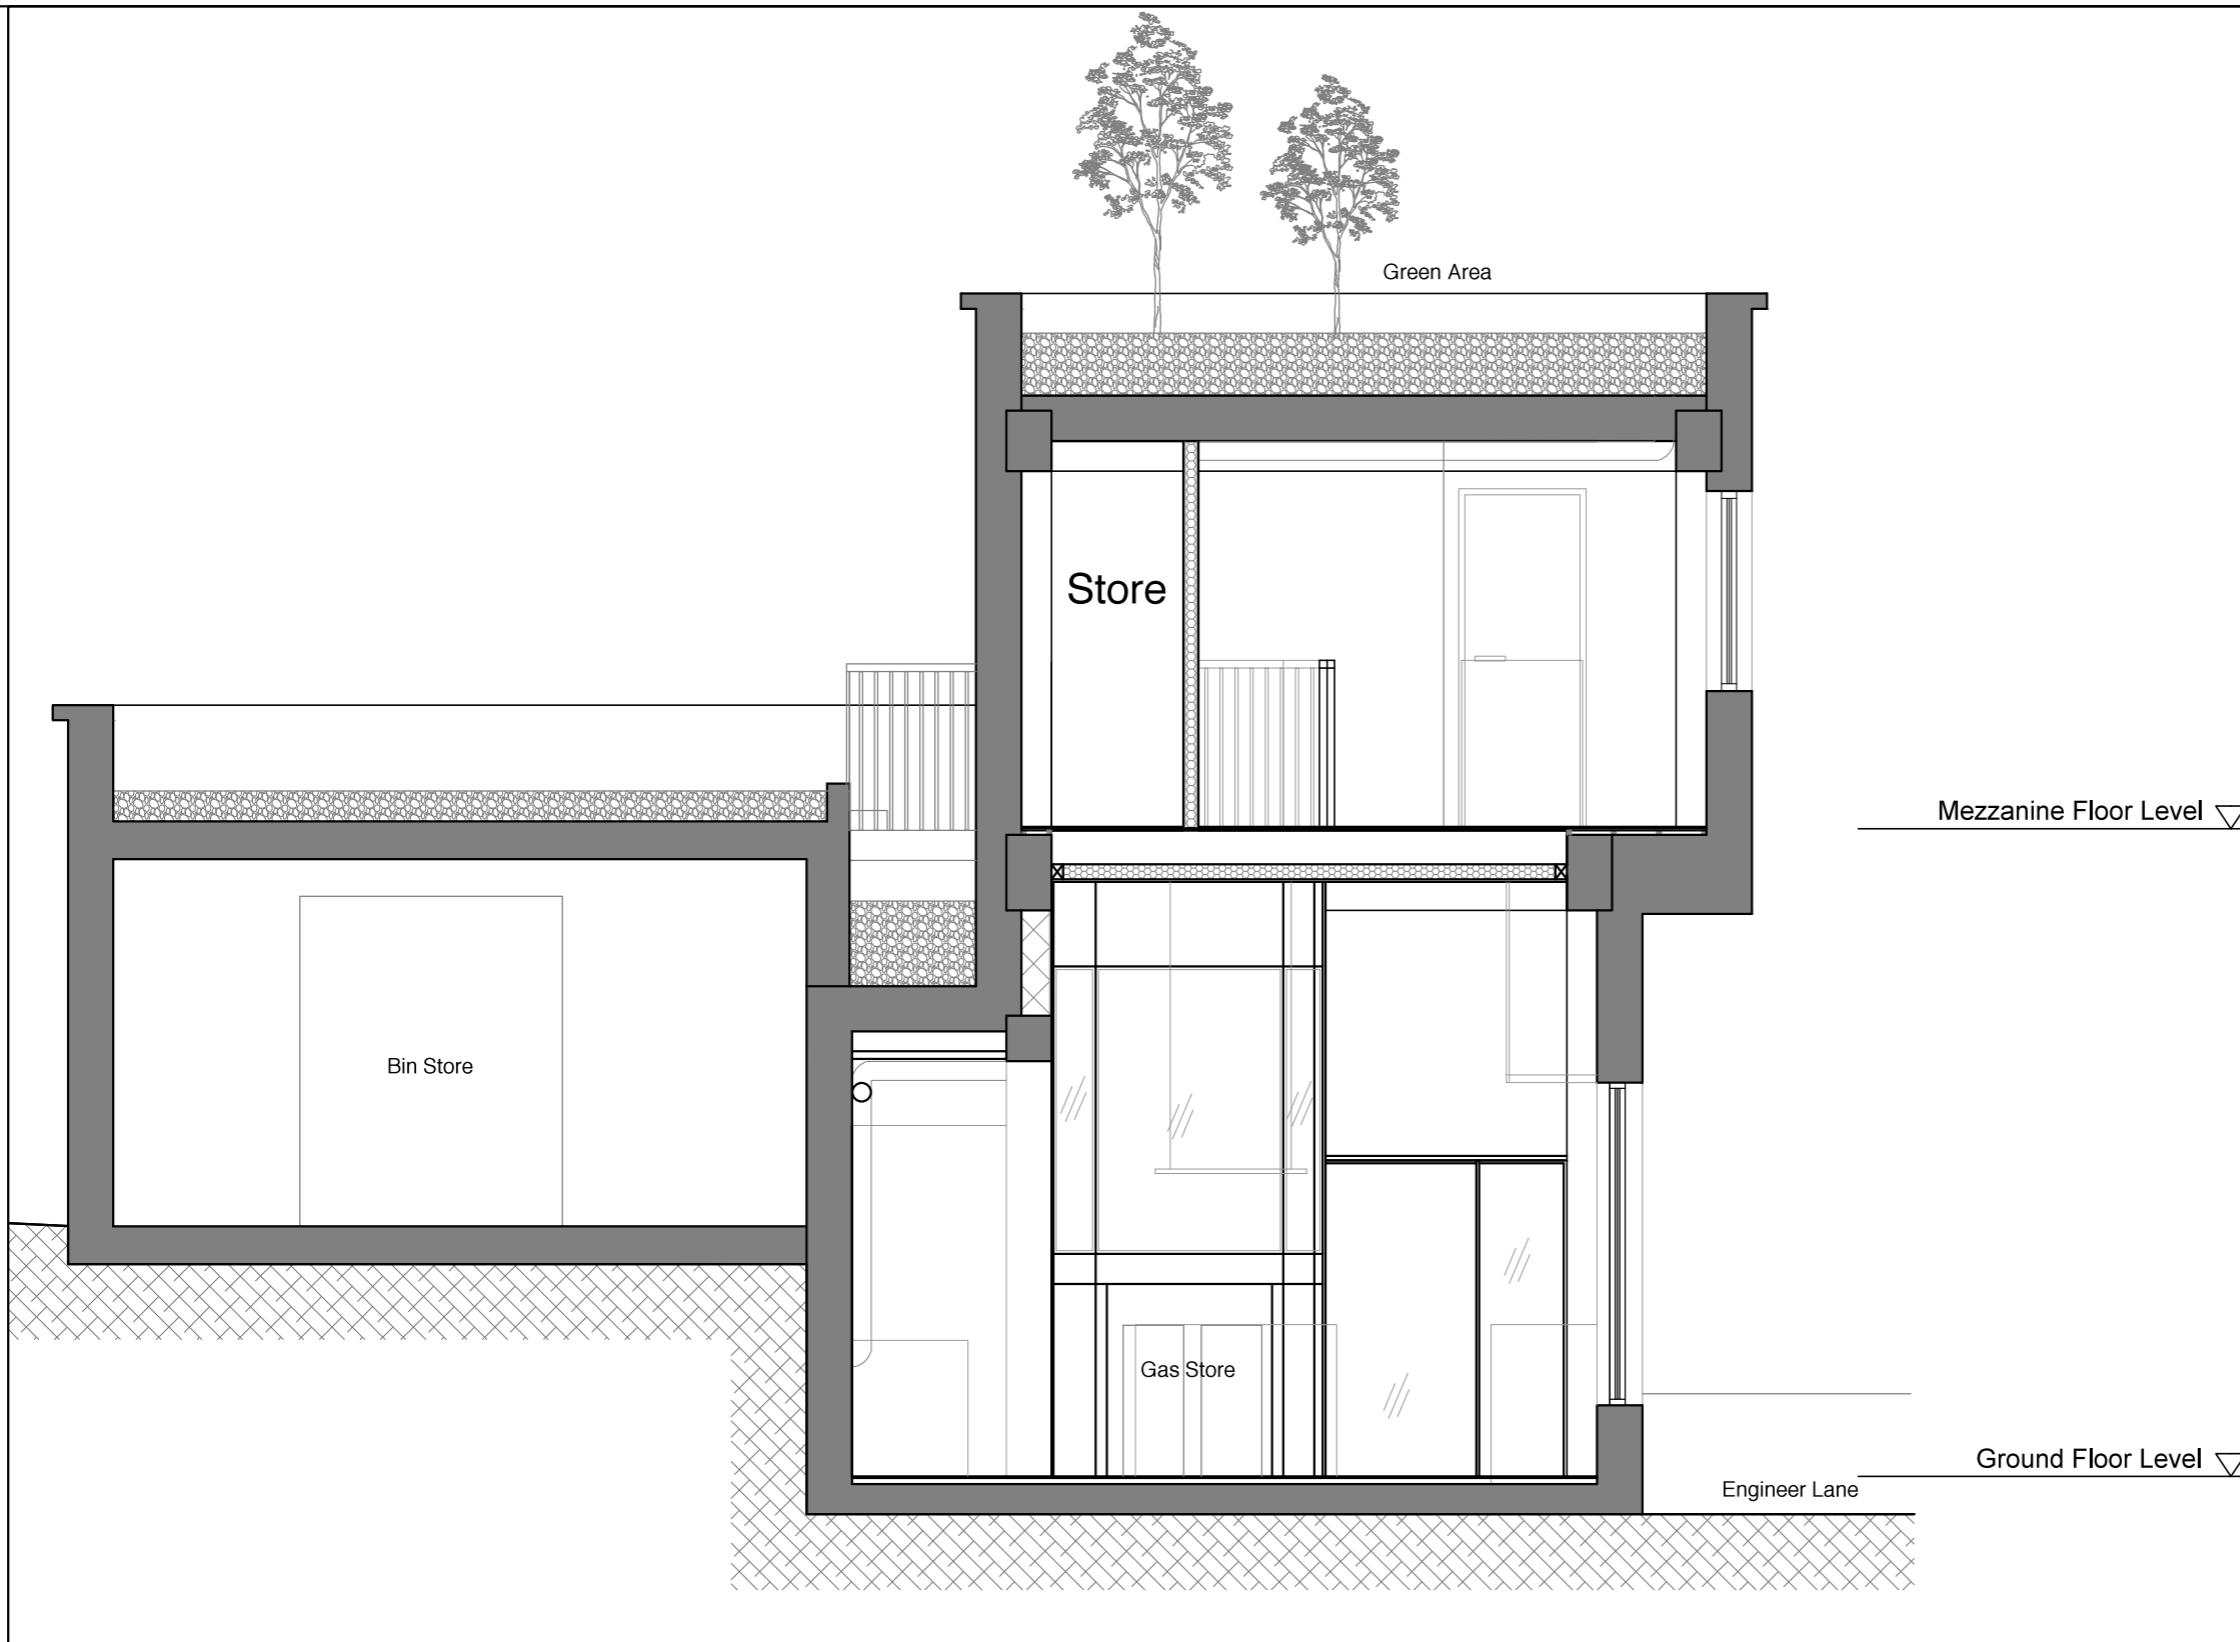


PROPOSED FIT-OUT OF PREMISES AND NEW MEZZANINE LEVEL  
- 37/A/2 ENGINEER LANE, GIB., FOR EXPECT GREATNESS LTD.

Project:  
**37/A/2 Engineer Lane**  
 Drg Title:  
**As-Built Section A-A'**


C	14.09.17	Drawing updated to reflect as built status		
Rev	Date	Comments		
Drawn by: VC	Checked/ Approved: SM	Date: 12.08.2016		
Job No.: <b>0349 - P05</b>	Media: <b>A3</b>			
Scale: <b>1:50</b>	Rev: <b>C</b>	Date: <b>14.09.17</b>		



Arc Designs Ltd  
 Unit 23B Casemates, Gibraltar  
 Tel: (+350) 20064512  
 E-mail: info@arc.gi

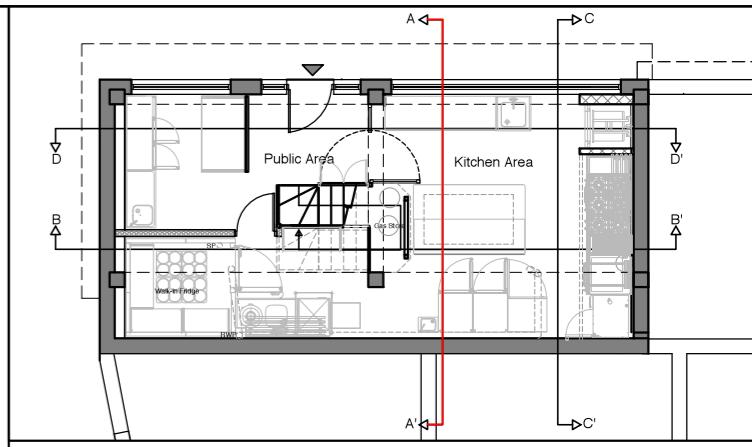


Key Plan  
nts

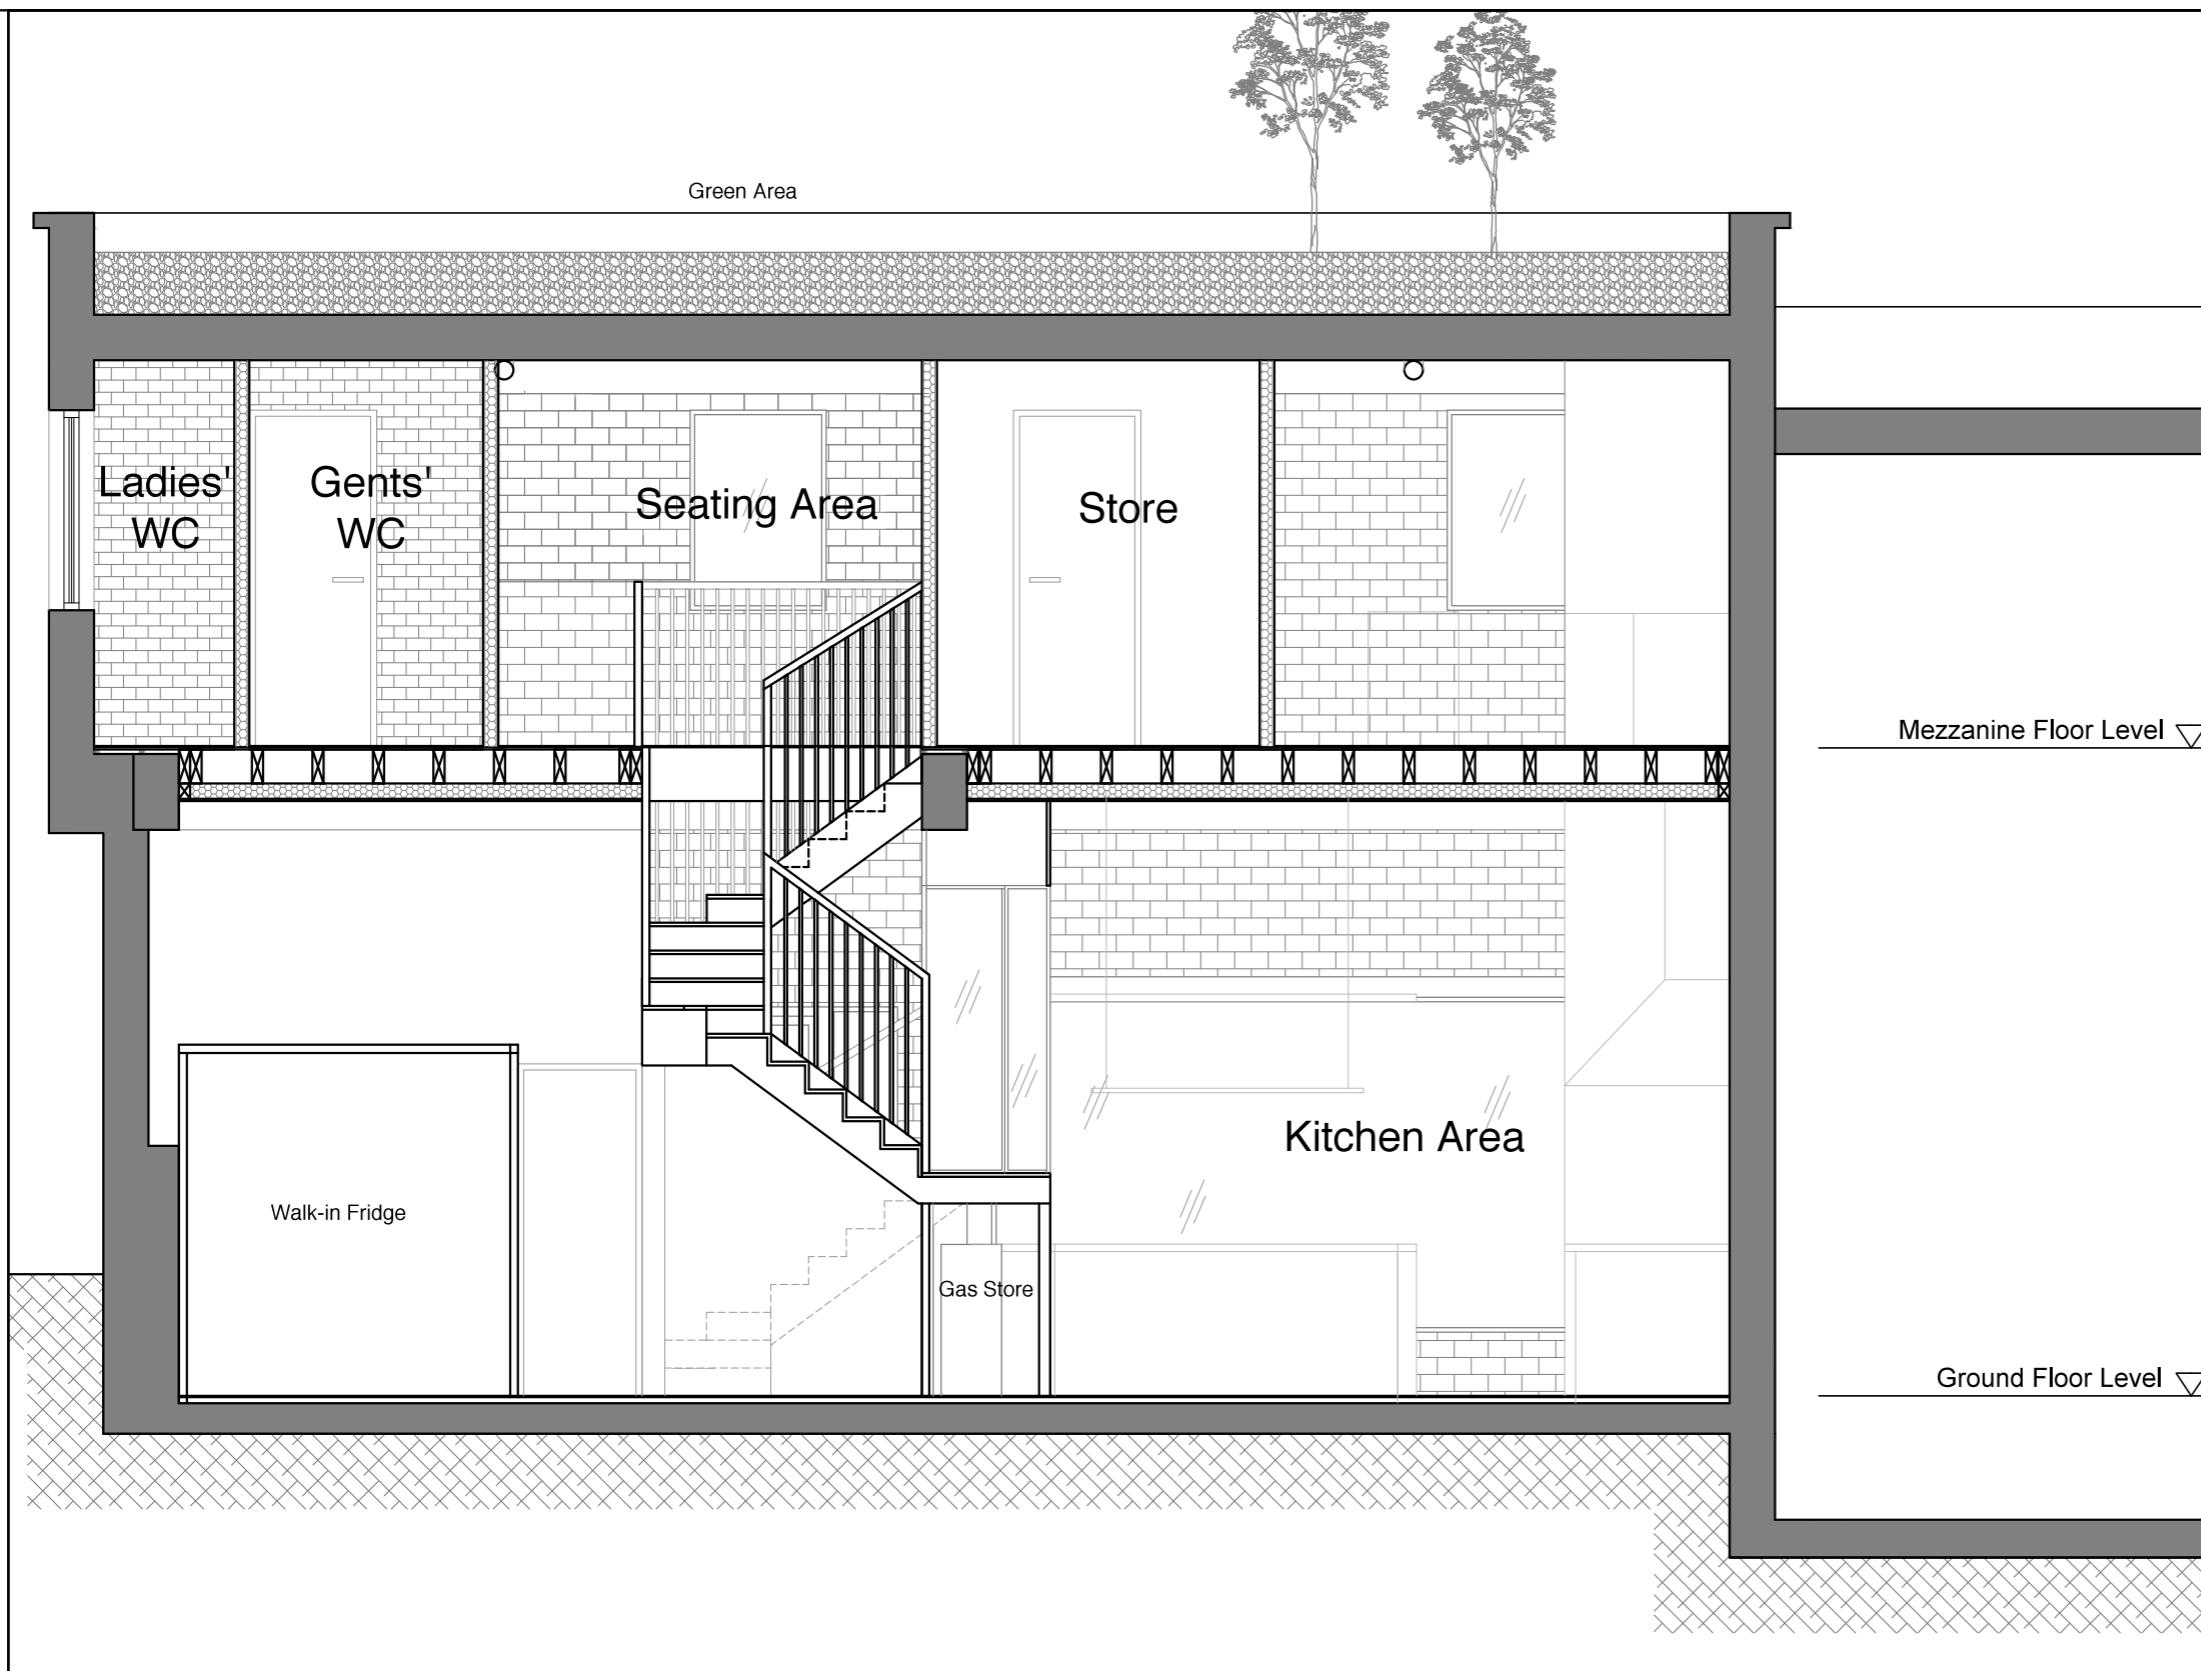

Section B-B' As-Built

Scale 1:50

PROPOSED FIT-OUT OF PREMISES AND NEW MEZZANINE LEVEL  
- 37/A/2 ENGINEER LANE, GIB., FOR EXPECT GREATNESS LTD.

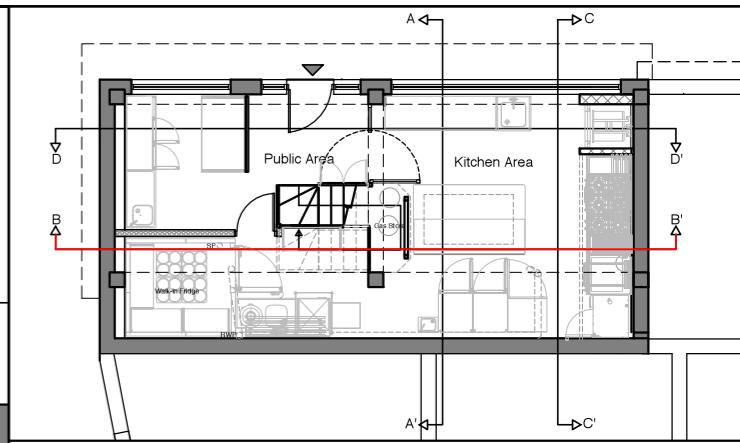


Key Plan  
nts

Project:  
**37/A/2 Engineer Lane**  
 Drg Title:  
**As-Built Section B-B'**


G	14.09.17	Drawing updated to reflect as built status		
Rev	Date	Comments		
Drawn by: VC	Checked/ Approved: SM	Date: 12.08.2016		
Job No.: <b>0349 - P06</b>	Media: <b>A3</b>			
Scale: <b>1:50</b>	Rev: <b>G</b>	Date: <b>14.09.17</b>		



Arc Designs Ltd  
 Unit 23B Casemates, Gibraltar  
 Tel: (+350) 20064512  
 E-mail: info@arc.gi

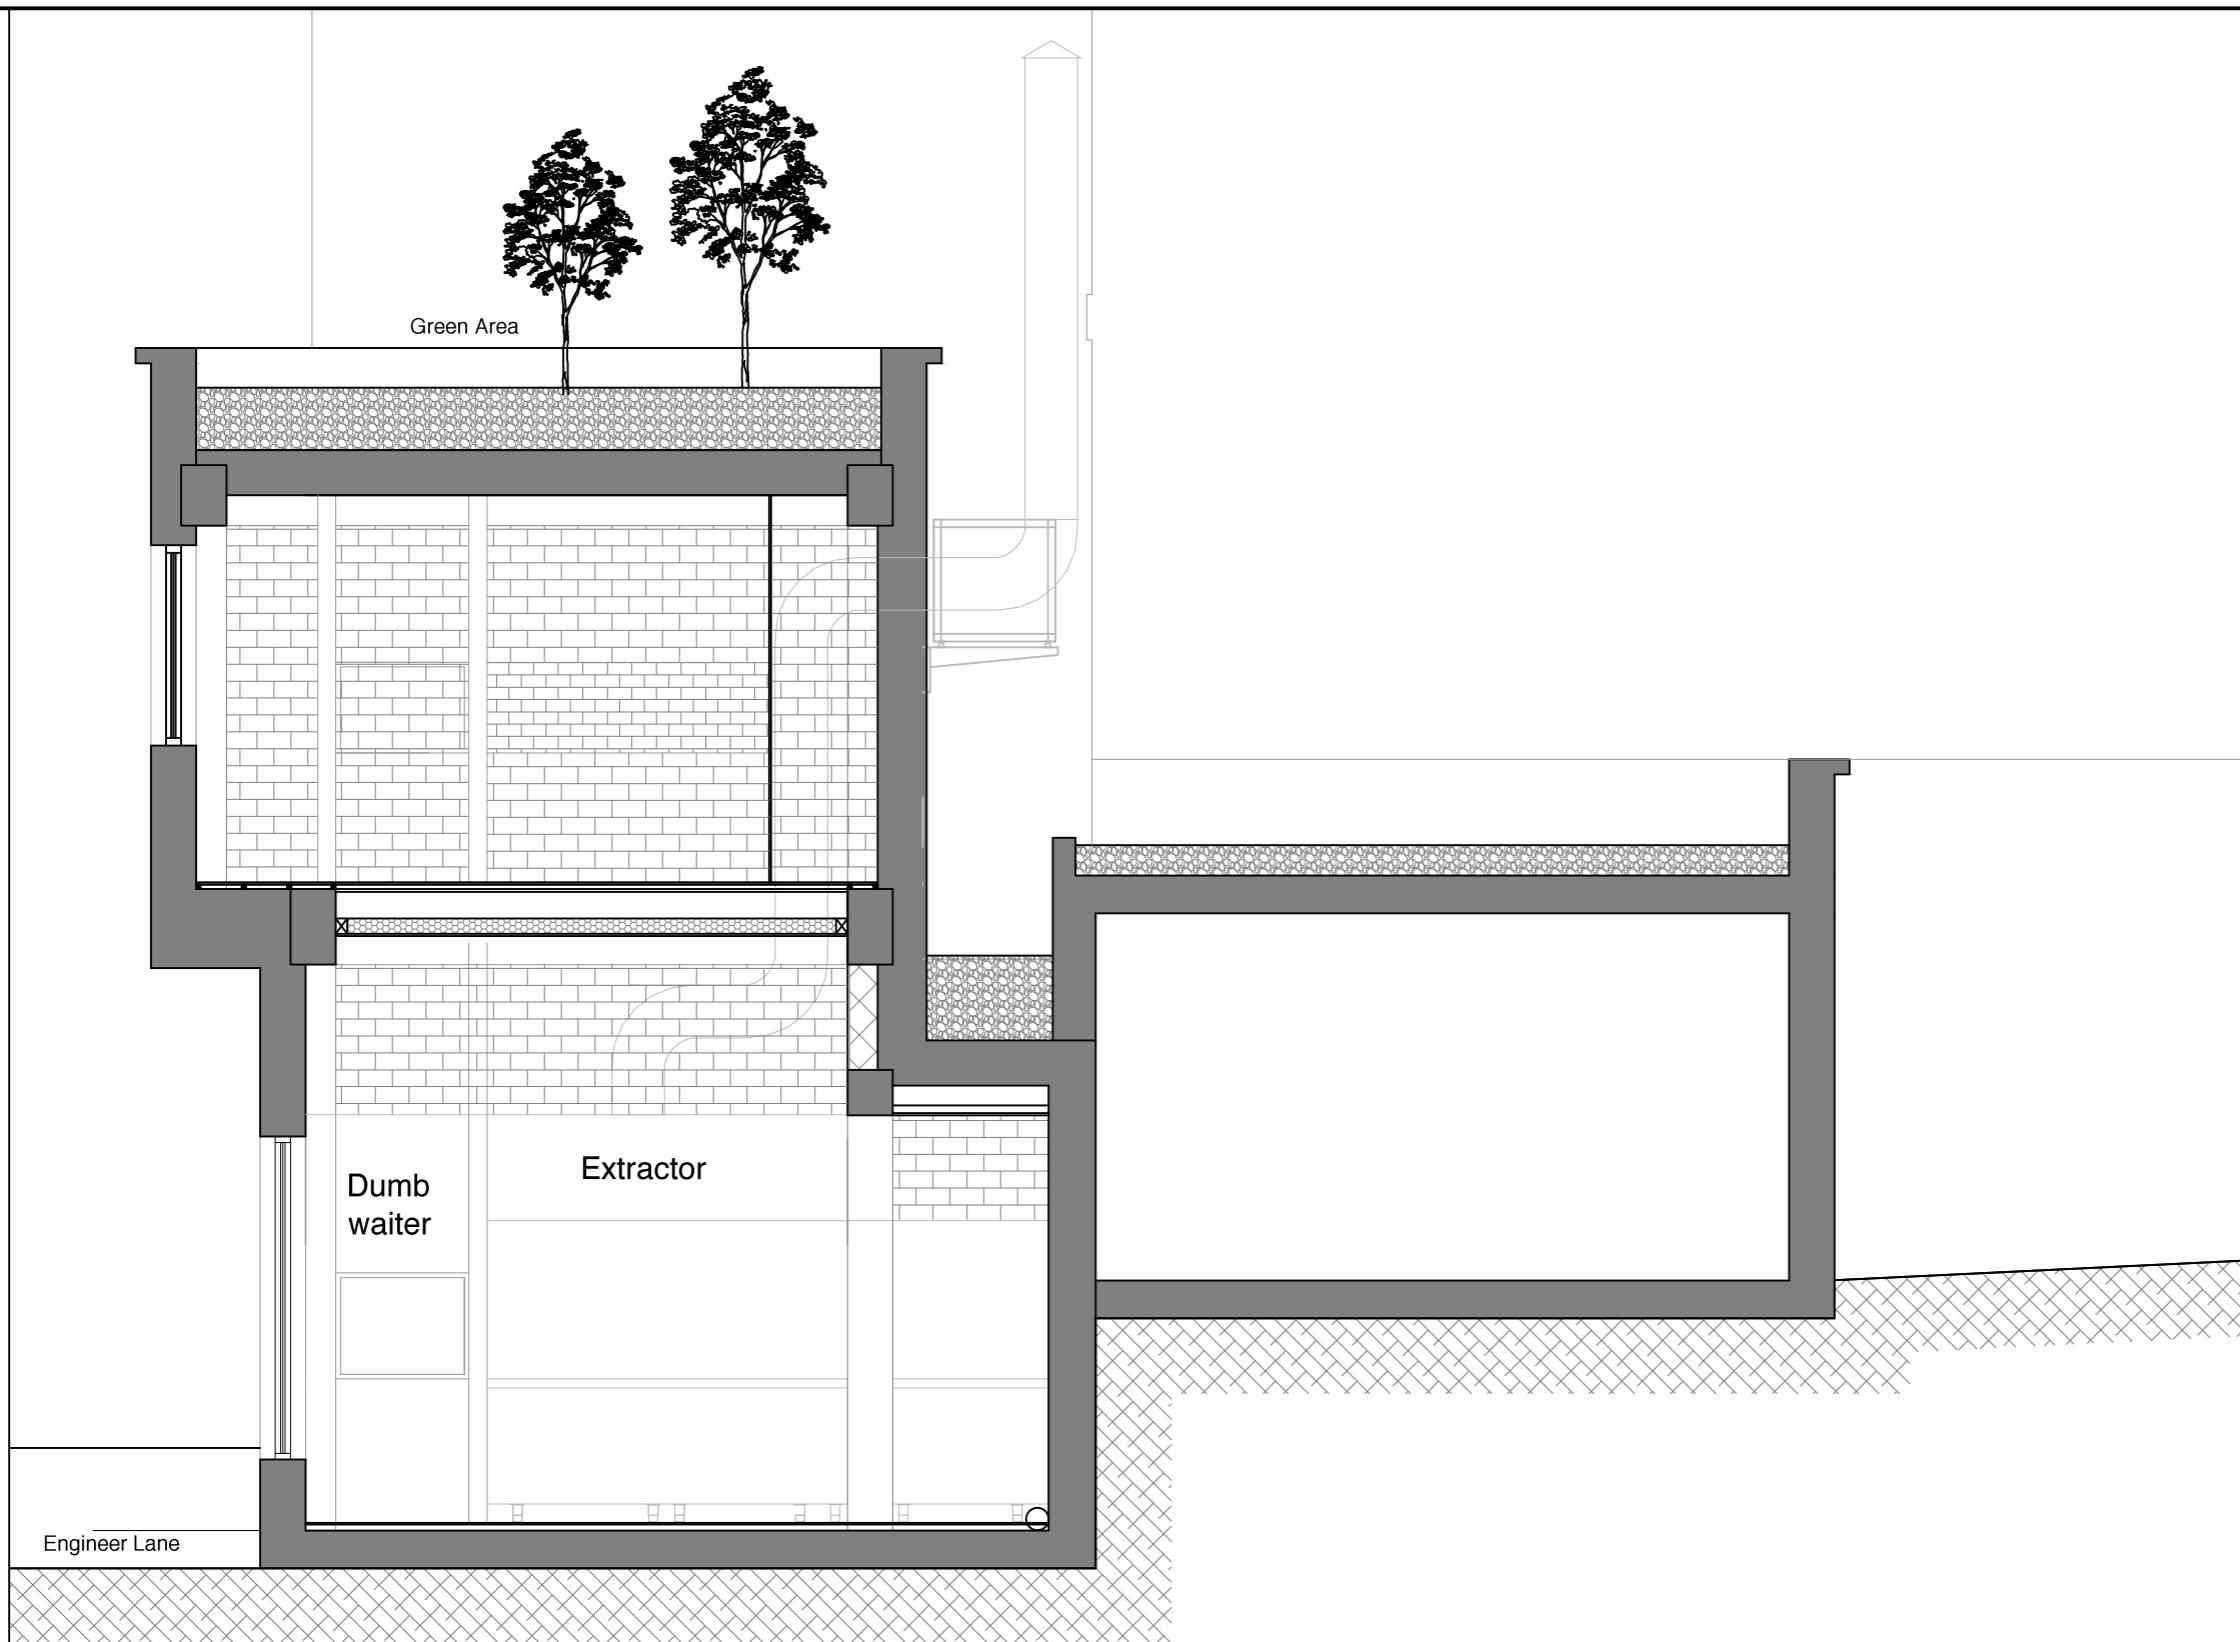


PROPOSED FIT-OUT OF PREMISES AND NEW MEZZANINE LEVEL  
- 37/A/2 ENGINEER LANE, GIB., FOR EXPECT GREATNESS LTD.

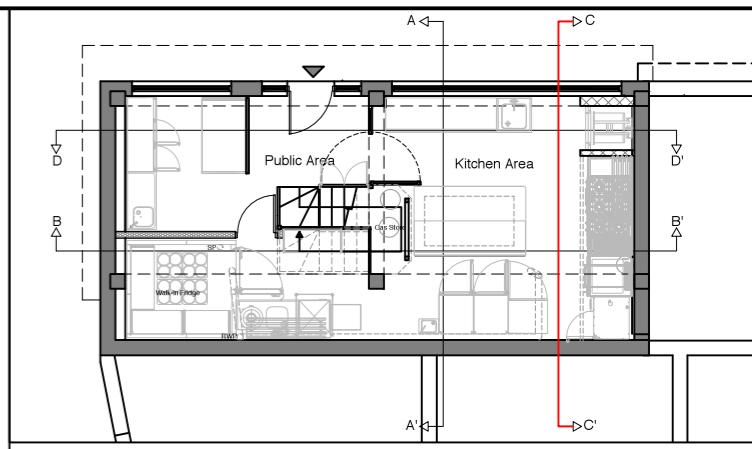

Key Plan  
nts


			B	14.09.17	Drawing updated to reflect as built status	
Project:			Rev	Date	Comments	
37/A/2 Engineer Lane			Drawn by:	Checked/ Approved:	Date:	
			VC	SM	17.02.2017	
Drg Title:			Job No.:	Media:		
0349 - P08			A3			
As-Built Section C-C'			Scale:	Rev:	Date:	
1:50			B	14.09.17		

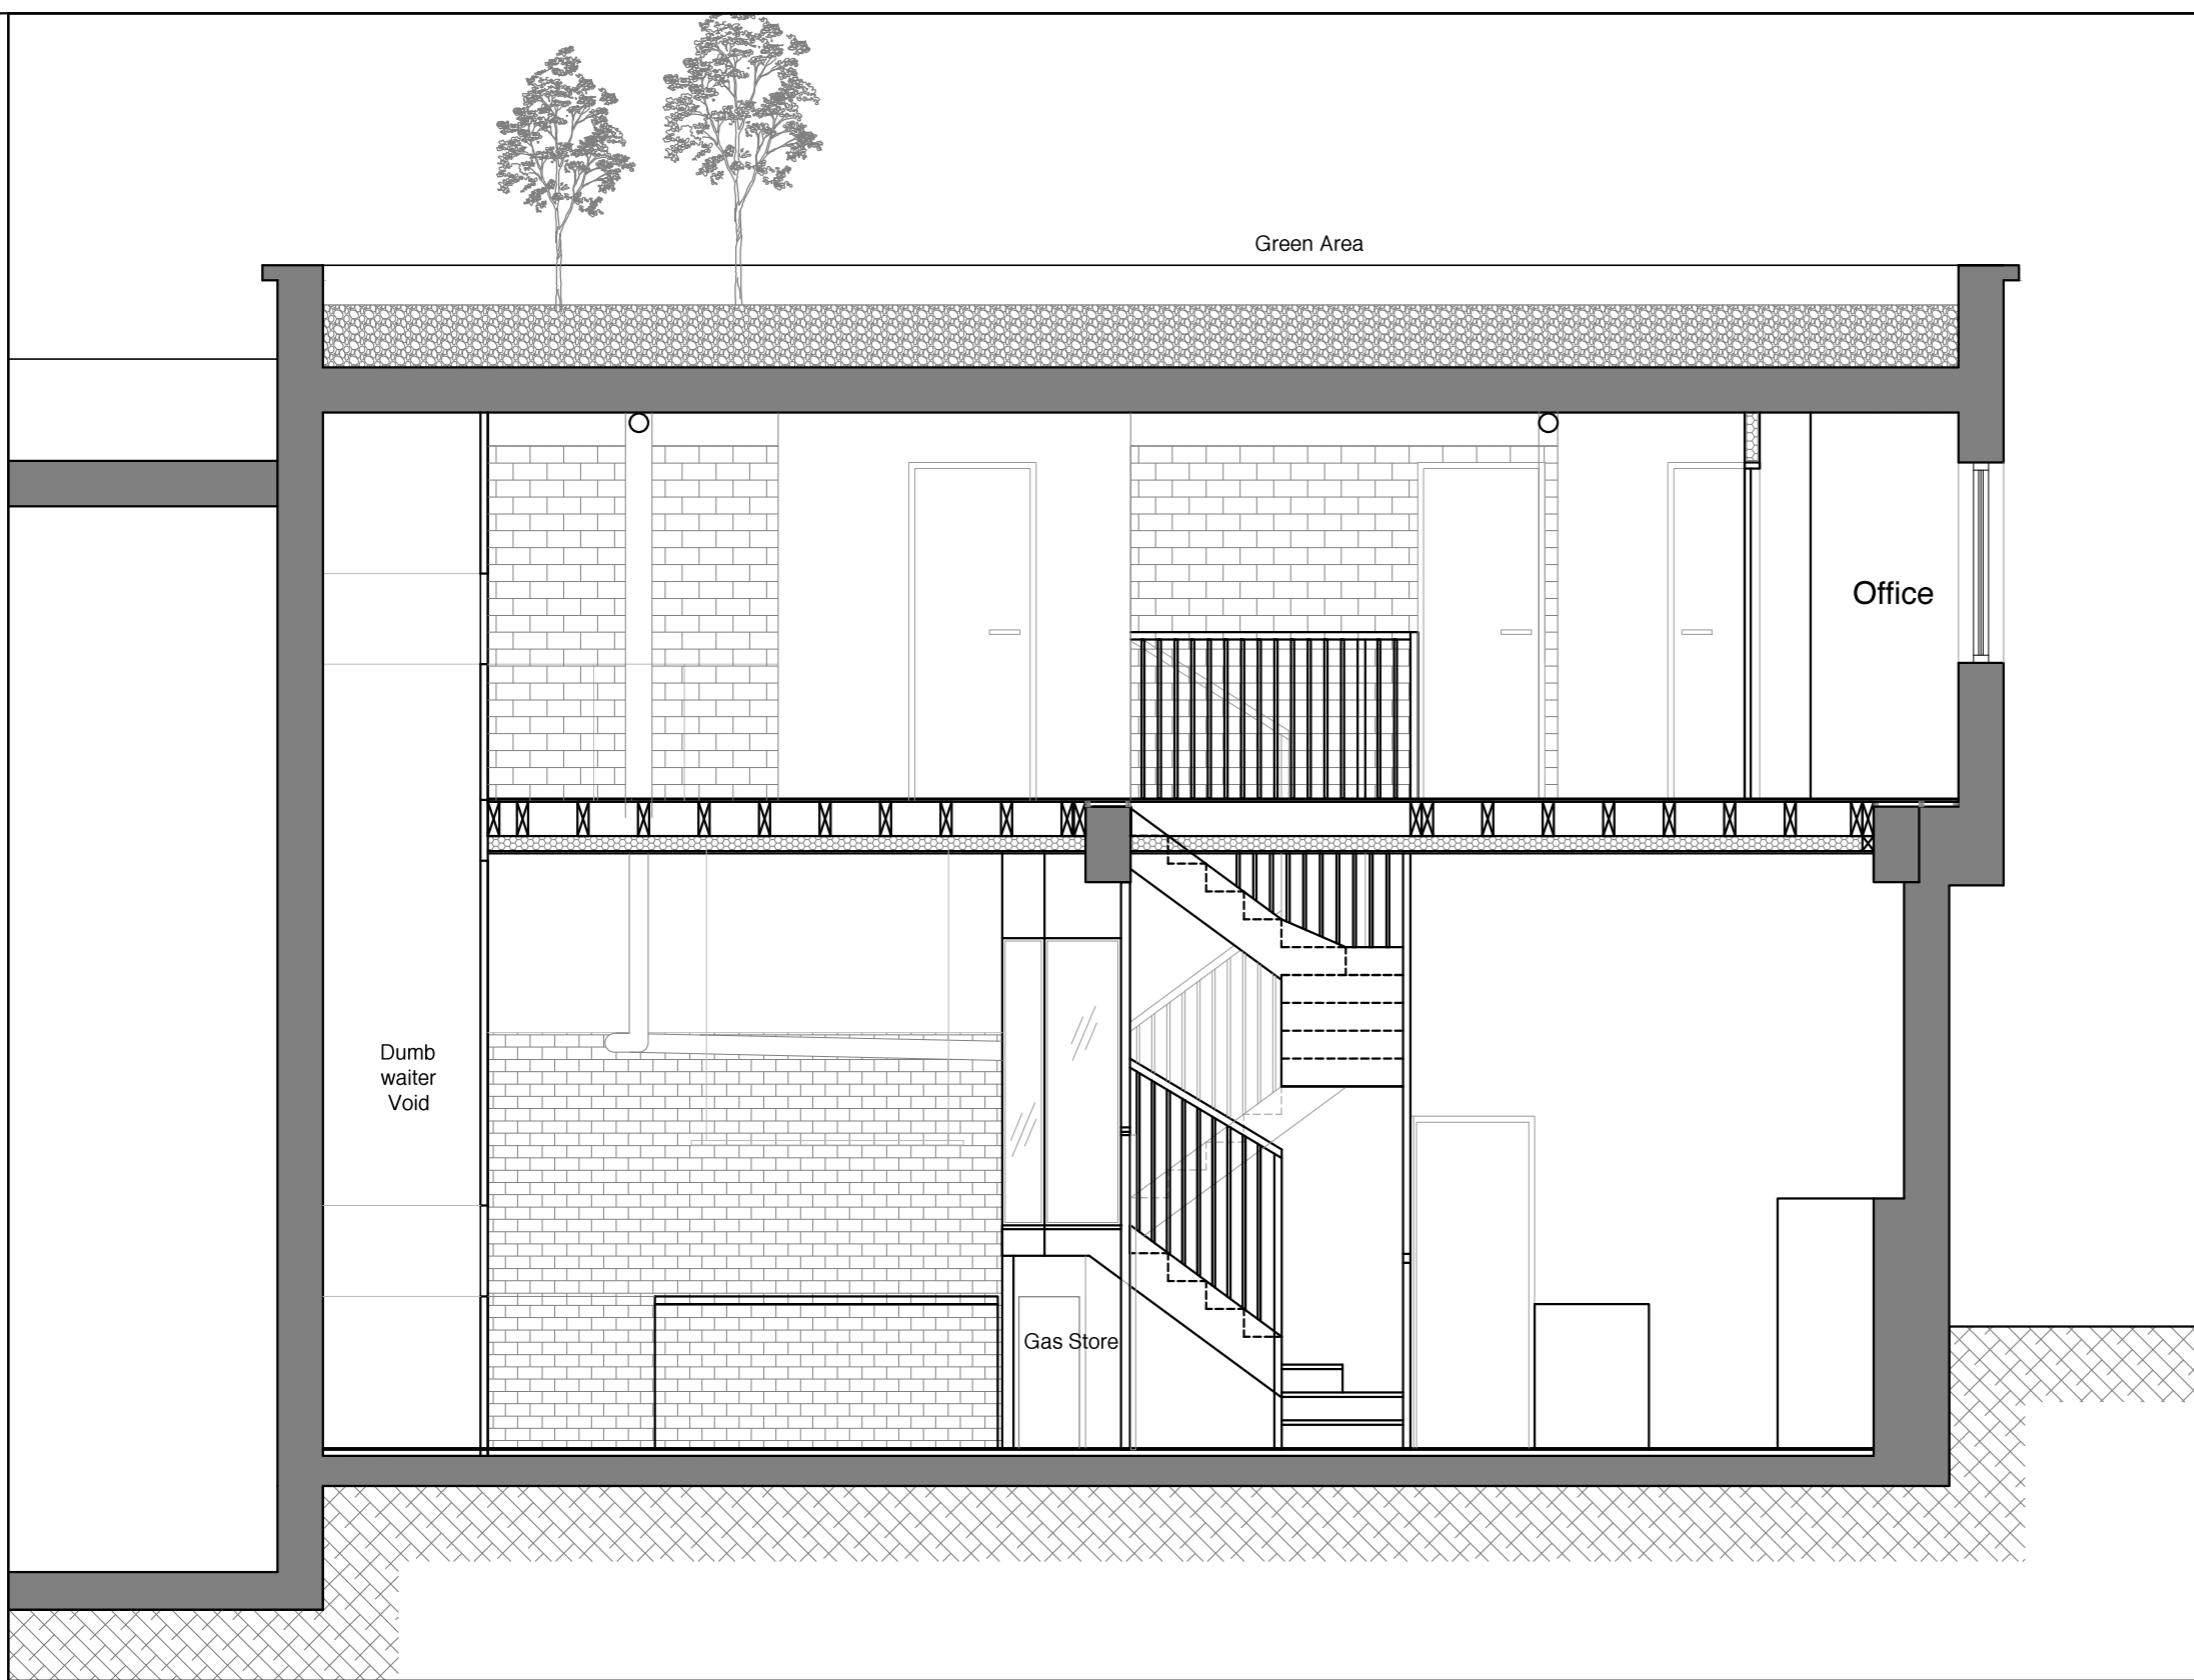

Section D-D'As-Built

Scale 1:50

PROPOSED FIT-OUT OF PREMISES AND NEW MEZZANINE LEVEL  
- 37/A/2 ENGINEER LANE, GIB., FOR EXPECT GREATNESS LTD.

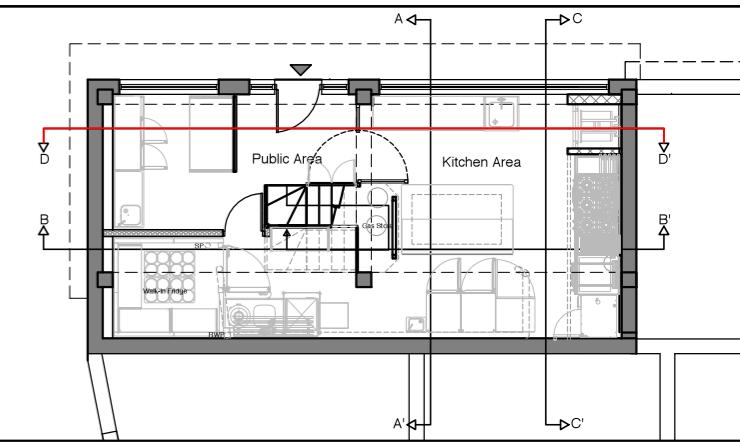


Key Plan  
nts

Project:  
**37/A/2 Engineer Lane**  
 Drg Title:  
**As-Built Section D-D'**

C	14.09.17	Drawing updated to reflect as built status		
Rev	Date	Comments		
Drawn by: VC	Checked/ Approved: SM	Date: 20.02.2017		
Job No.: <b>0349 - P09</b>	Media: <b>A3</b>			
Scale: <b>1:50</b>	Rev: <b>C</b>	Date: <b>14.09.17</b>		






Arc Designs Ltd  
 Unit 23B Casemates, Gibraltar  
 Tel: (+350) 20064512  
 E-mail: info@arc.gi

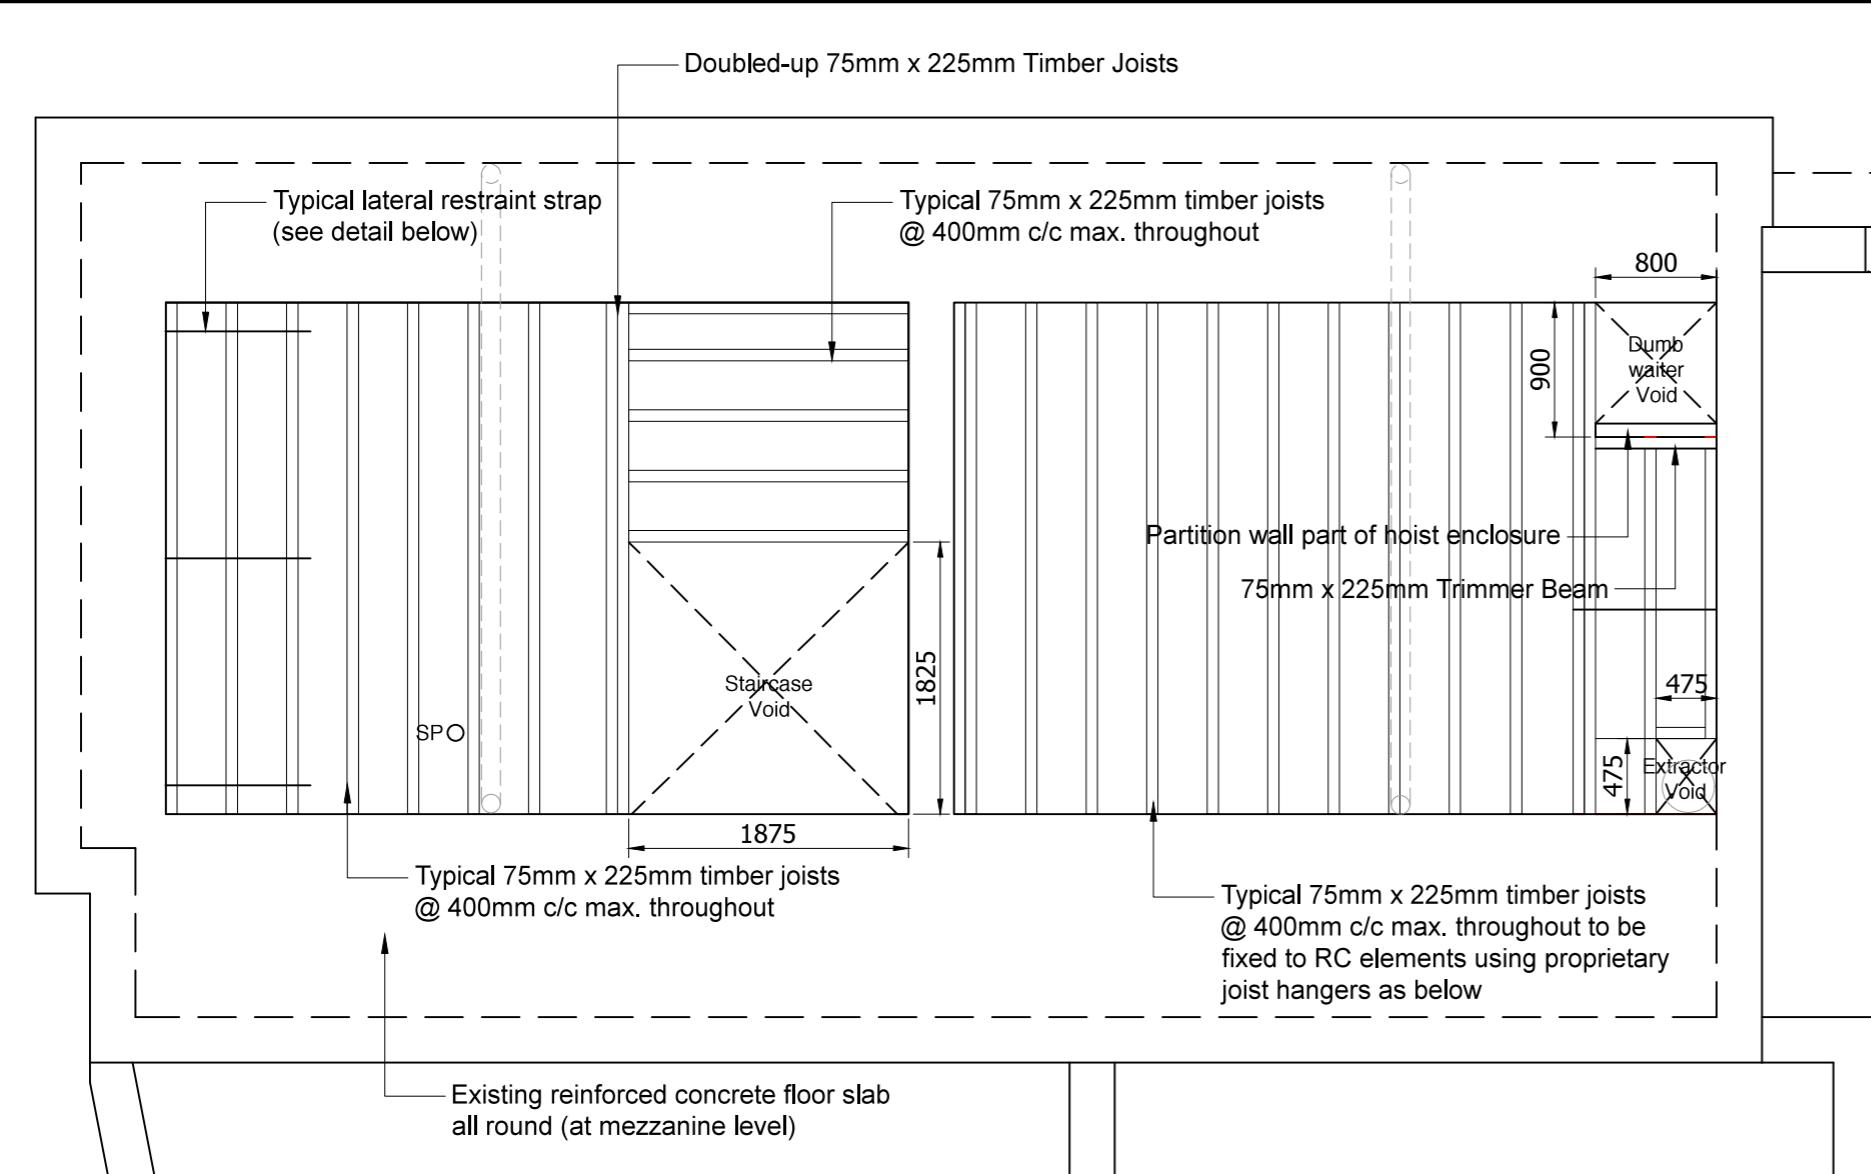

### Structural Layout - As-Built

Scale 1:50

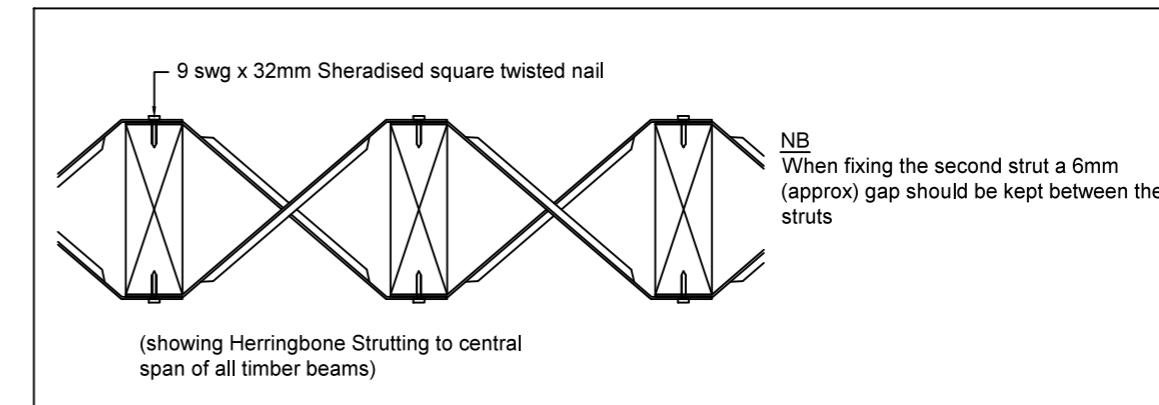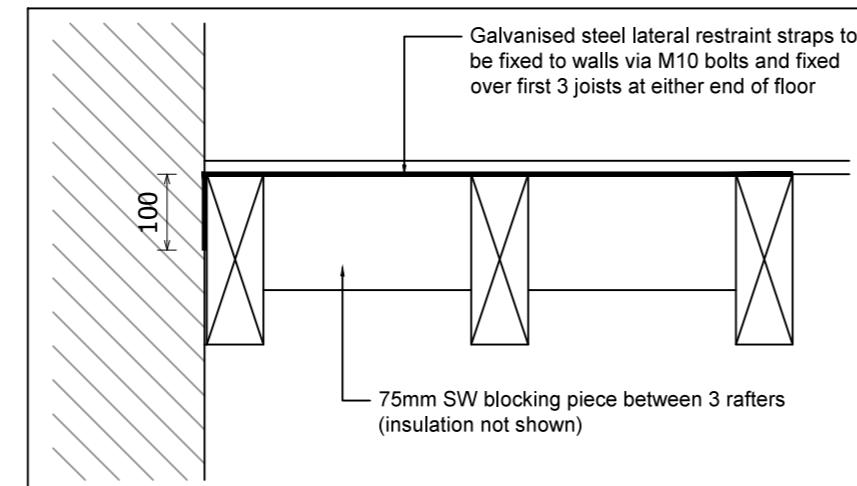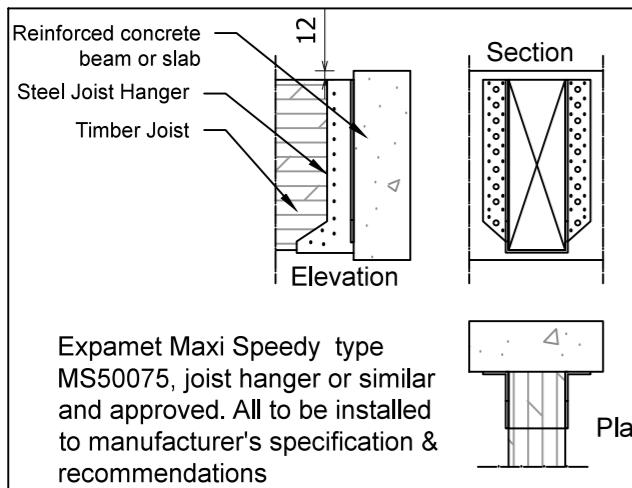


Herringbone Joist Strut Fixing Detail to Centre of Beam Spans  
Scale 1:10

### Steel Joist Hanger Detail

Scale 1:10

**PROPOSED FIT-OUT OF PREMISES AND NEW MEZZANINE LEVEL**  
- 37/A/2 ENGINEER LANE, GIB., FOR EXPECT GREATNESS LTD.

Drawing updated to reflect as built status			
Project:	D	02.10.17	Comments
Drawn by:	Rev	Date	
37/A/2 Engineer Lane	VC	SM	12.08.2016
Drg Title:	Job No.:	Media:	
As-Built Structural Layout	0349 - S01	A3	
Scale:	Rev:	Date:	
1:50	D	02.10.17	

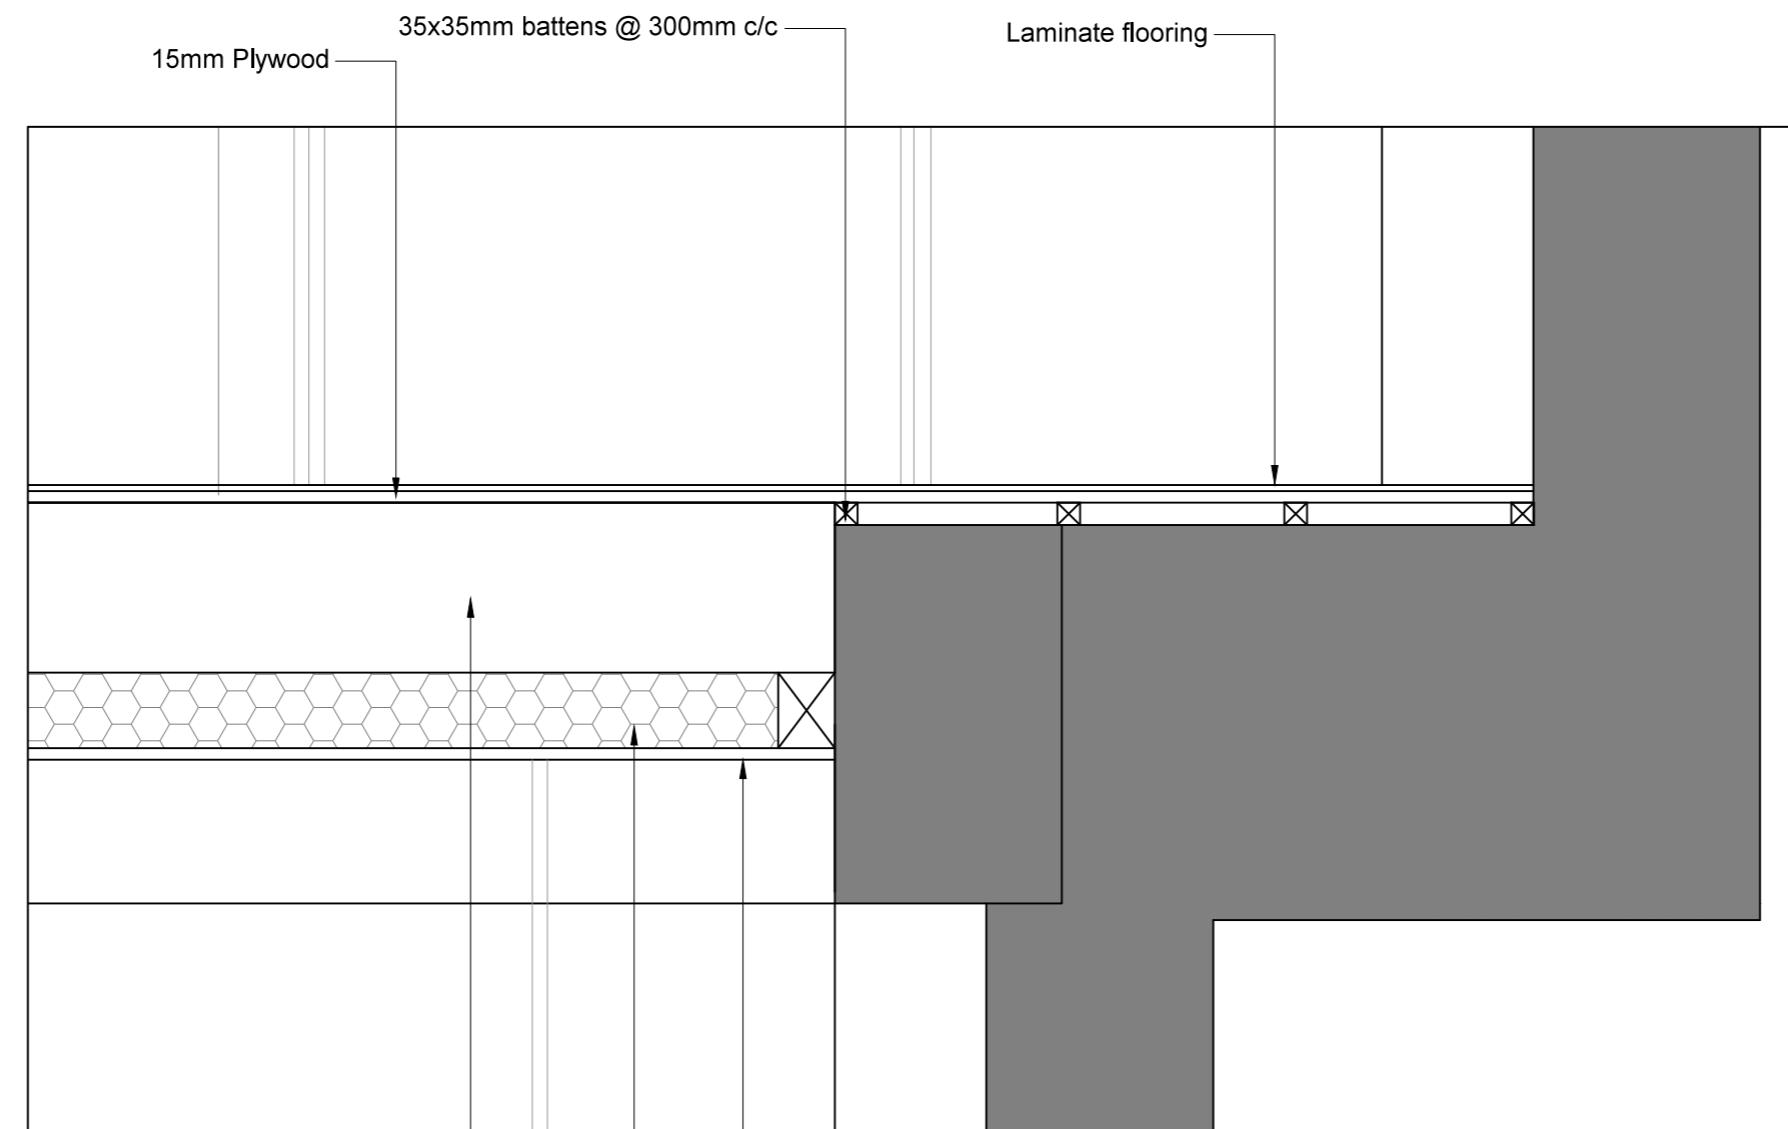

## Mezzanine Floor Detail

Scale 1:1

— 1/2 Hour (12mm thk) Plasterboard  
fixed to secondary timber structure

— 60mm Rockwool insulation

- Typical 75mm x 225mm timber joists @ 400mm c/c max. throughout to be fixed to RC elements using proprietary joist hangers

**PROPOSED FIT-OUT OF PREMISES AND NEW MEZZANINE LEVEL  
- 37/A/2 ENGINEER LANE, GIB., FOR EXPECT GREATNESS LTD.**

Project: 37/A/2 Engineer Lane

-	-	-
Rev	Date	Comments
Drawn by:  VC	Checked/ Approved:  SM	Date:  12.08.2016
Job No.:  0349 - D01		Media:  A3
Scale:  1:10	Rev:  -	Date:  -
 Arc Designs Ltd Unit 23B Casemates, Gibraltar Tel: (+350) 20064512 E-mail: info@arc.gi		



Arc Designs Ltd  
Unit 23B Casemates, Gibraltar  
Tel: (+350) 20064512  
E-mail: [info@arc.gi](mailto:info@arc.gi)